

Finland bid 2017 ISRA Worlds


Finland situated in the Northern Europe. Located between East and West, it is bordered by Sweden to the west, Russia to the east and Estonia to the south over the Gulf of Finland.

City by the Sea

Kotka is the second largest city in Kymenlaakso County. It is located on the coast of the Baltic Sea, the Gulf of Finland, at the estuary of Kymi river. Kotka is known by its port, industry and maritime festivals. Kotka is also known as a multifaceted city of educational institutions and culture.

Kotka in brief

Kotka was founded in 1878. Now the population is about 55.000. The area is 750 km², but most of it is water, 272 km² island. Kotka is located 130 km east from Helsinki and 290 km west from St. Petersburg; the highway no 18 runs through Kotka. In the city there are two centres, Kotkansaari (the Isle of Kotka) and Karhula.

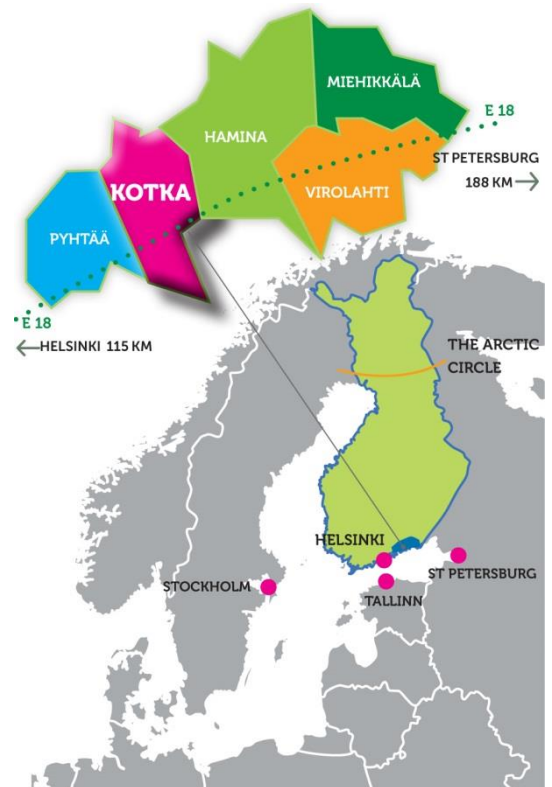

Location and accommodation

The competition venue is an old newspaper printing house at Kotkantie 6. Facilities are in connection with a restaurant. To the nearest accommodation places have a couple of kilometers. Hotels have accommodation for 170 people in Kotka area.

More information on accommodation [http://www.kaakko135.fi/en/services?&kategoria\[0\]=7&title=&page=1](http://www.kaakko135.fi/en/services?&kategoria[0]=7&title=&page=1)

Track


Track is designed by Kimmo Rautama and built by Janis Nabokins and Peteris Taurins. Track was installed on the August 2014. Track length is 46,3m. Track is powered with 12.5V, 350 Amps power supply. Track has Lap Master lap-counter with optical sensors.



KOTKA TRACK
VERSION 12.22
03.03.2014 KIMMO RAUTAMA


LENGTH 46.3m
LANE SPACING 110mm

SCALE 1:50
UNITS mm

CHANGES TO 12.21 MARKED WITH 

COLORS:

1. TRACK SURFACE: GREY (CMYK 0c, 0m, 0y, 70k)
2. TRACK SIDES: BLUE (Pantone PMS 3005, CMYK 100c, 30m, 0y, 0k)
3. DRIVERS' PANEL: BLUE (Pantone Process Cyan, CMYK 100c, 0m, 0y, 0k)

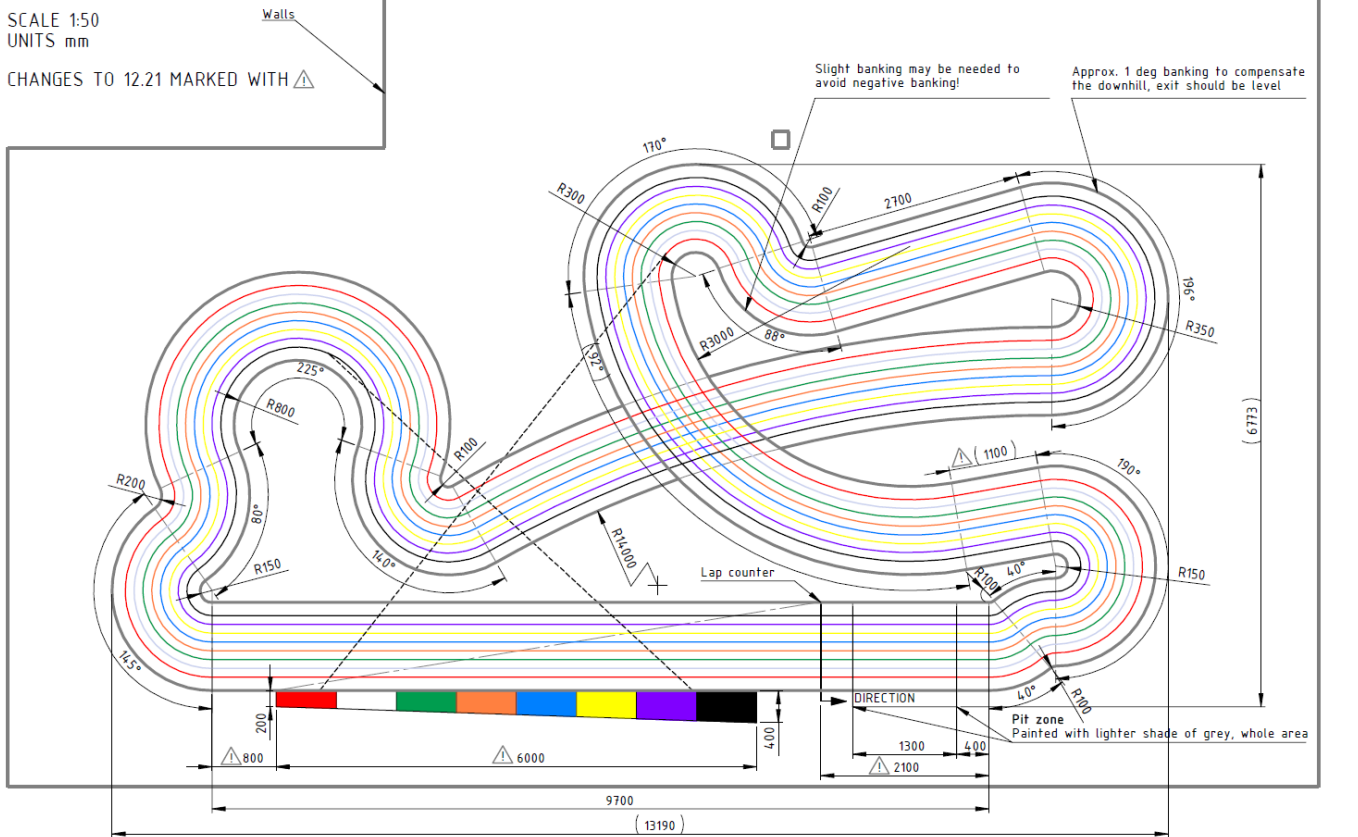

Warm up races

We will organize Finnish national championship race on April 2015 and we have planned to organize NEC race on 2015 or 2016. We will organize warm up race on May 2017.

Contact information

Tomi Pahula

tomi.pahula@gmail.com

+358445660499